

WEST END ROAD


Easting, Northing:  
XY = 499276.798, 247591.499

This drawing is the copyright of Renewable Connections and must not be reproduced or used in whole or in part or used in any manner without their written permission.  
All dimensions are to be confirmed on site prior to commencement of work.


Revisions:				
Revision	Date	Revision Notes	Drawn	Inspected
01	02.08.21	Final Issue	MC	TG
02	17.08.21	Red Line Amendments	PL	TG
03	18.08.21	Red Line Amendments	PL	TG
04	23.08.21	Red Line Amendments	PL	TG
05	25.08.21	Revised	PL	TG
07	19.10.21	Revised	PL	TG

LEGEND:

	CRANFIELD ROAD SOLAR SITE BOUNDARY		CABLE EASEMENT
	DND ACCESS		PERIMETER FENCELINE
	EXISTING OH CABLE ROUTE		PROPOSED HIGHWAYS CABLE ROUTE
	PROPOSED HIGHWAYS CABLE ROUTE		SECURITY GATE

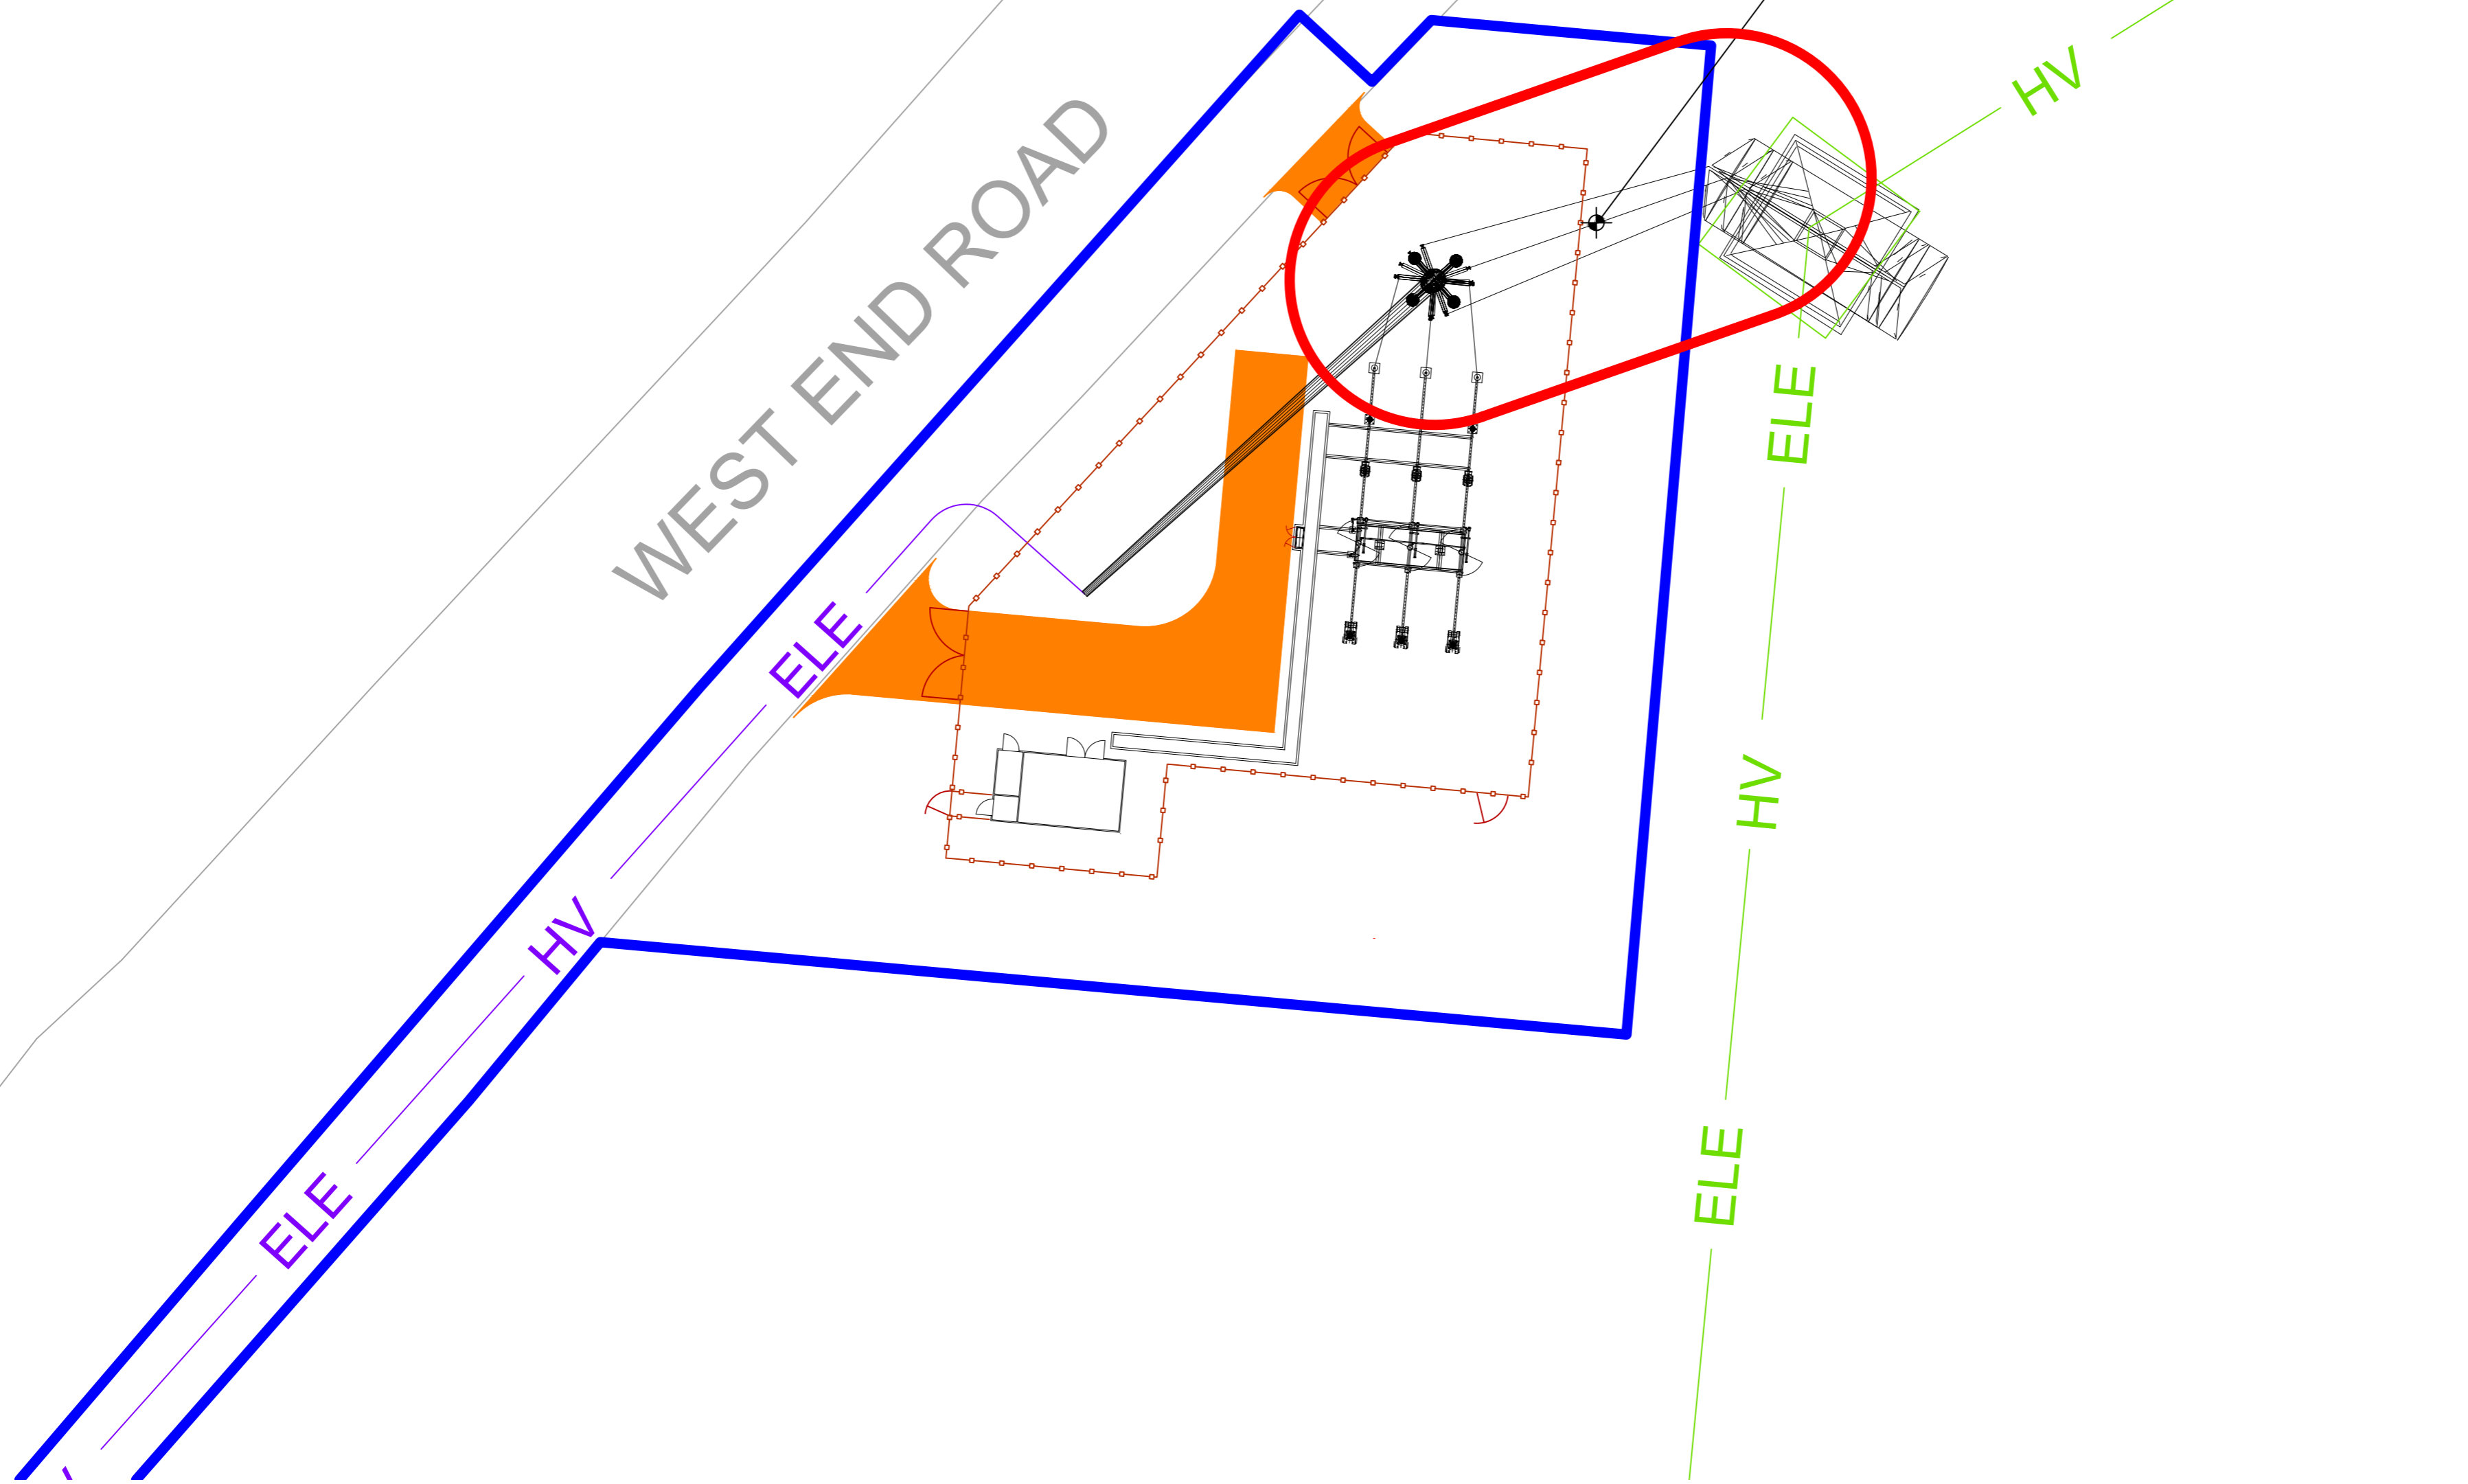

1 NORTH CRAWLEY POC LAYOUT  
Scale: 1:250@A2

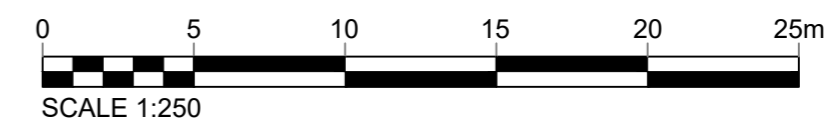

Status: **FOR PLANNING**

Project: **North Crawley Solar Farm**

3rd Floor, 141 - 145 Cranford Road, London, EC1A 3BK  
Tel: +44 (0)20 7148 2400  
enquiries@renewableconnections.co.uk  
www.renewableconnections.co.uk

Drawing Title: **North Crawley Solar Farm POC Layout Plan**

Drawn: MC	Checked: TG	First Issued: 02.08.2021
Project Code: RNC001- PL-03	Drawing Number:	
Sheet Size: A2	Scale: 1:250	Revision: 07